



Proposed Location for
1,000 gal propane tank

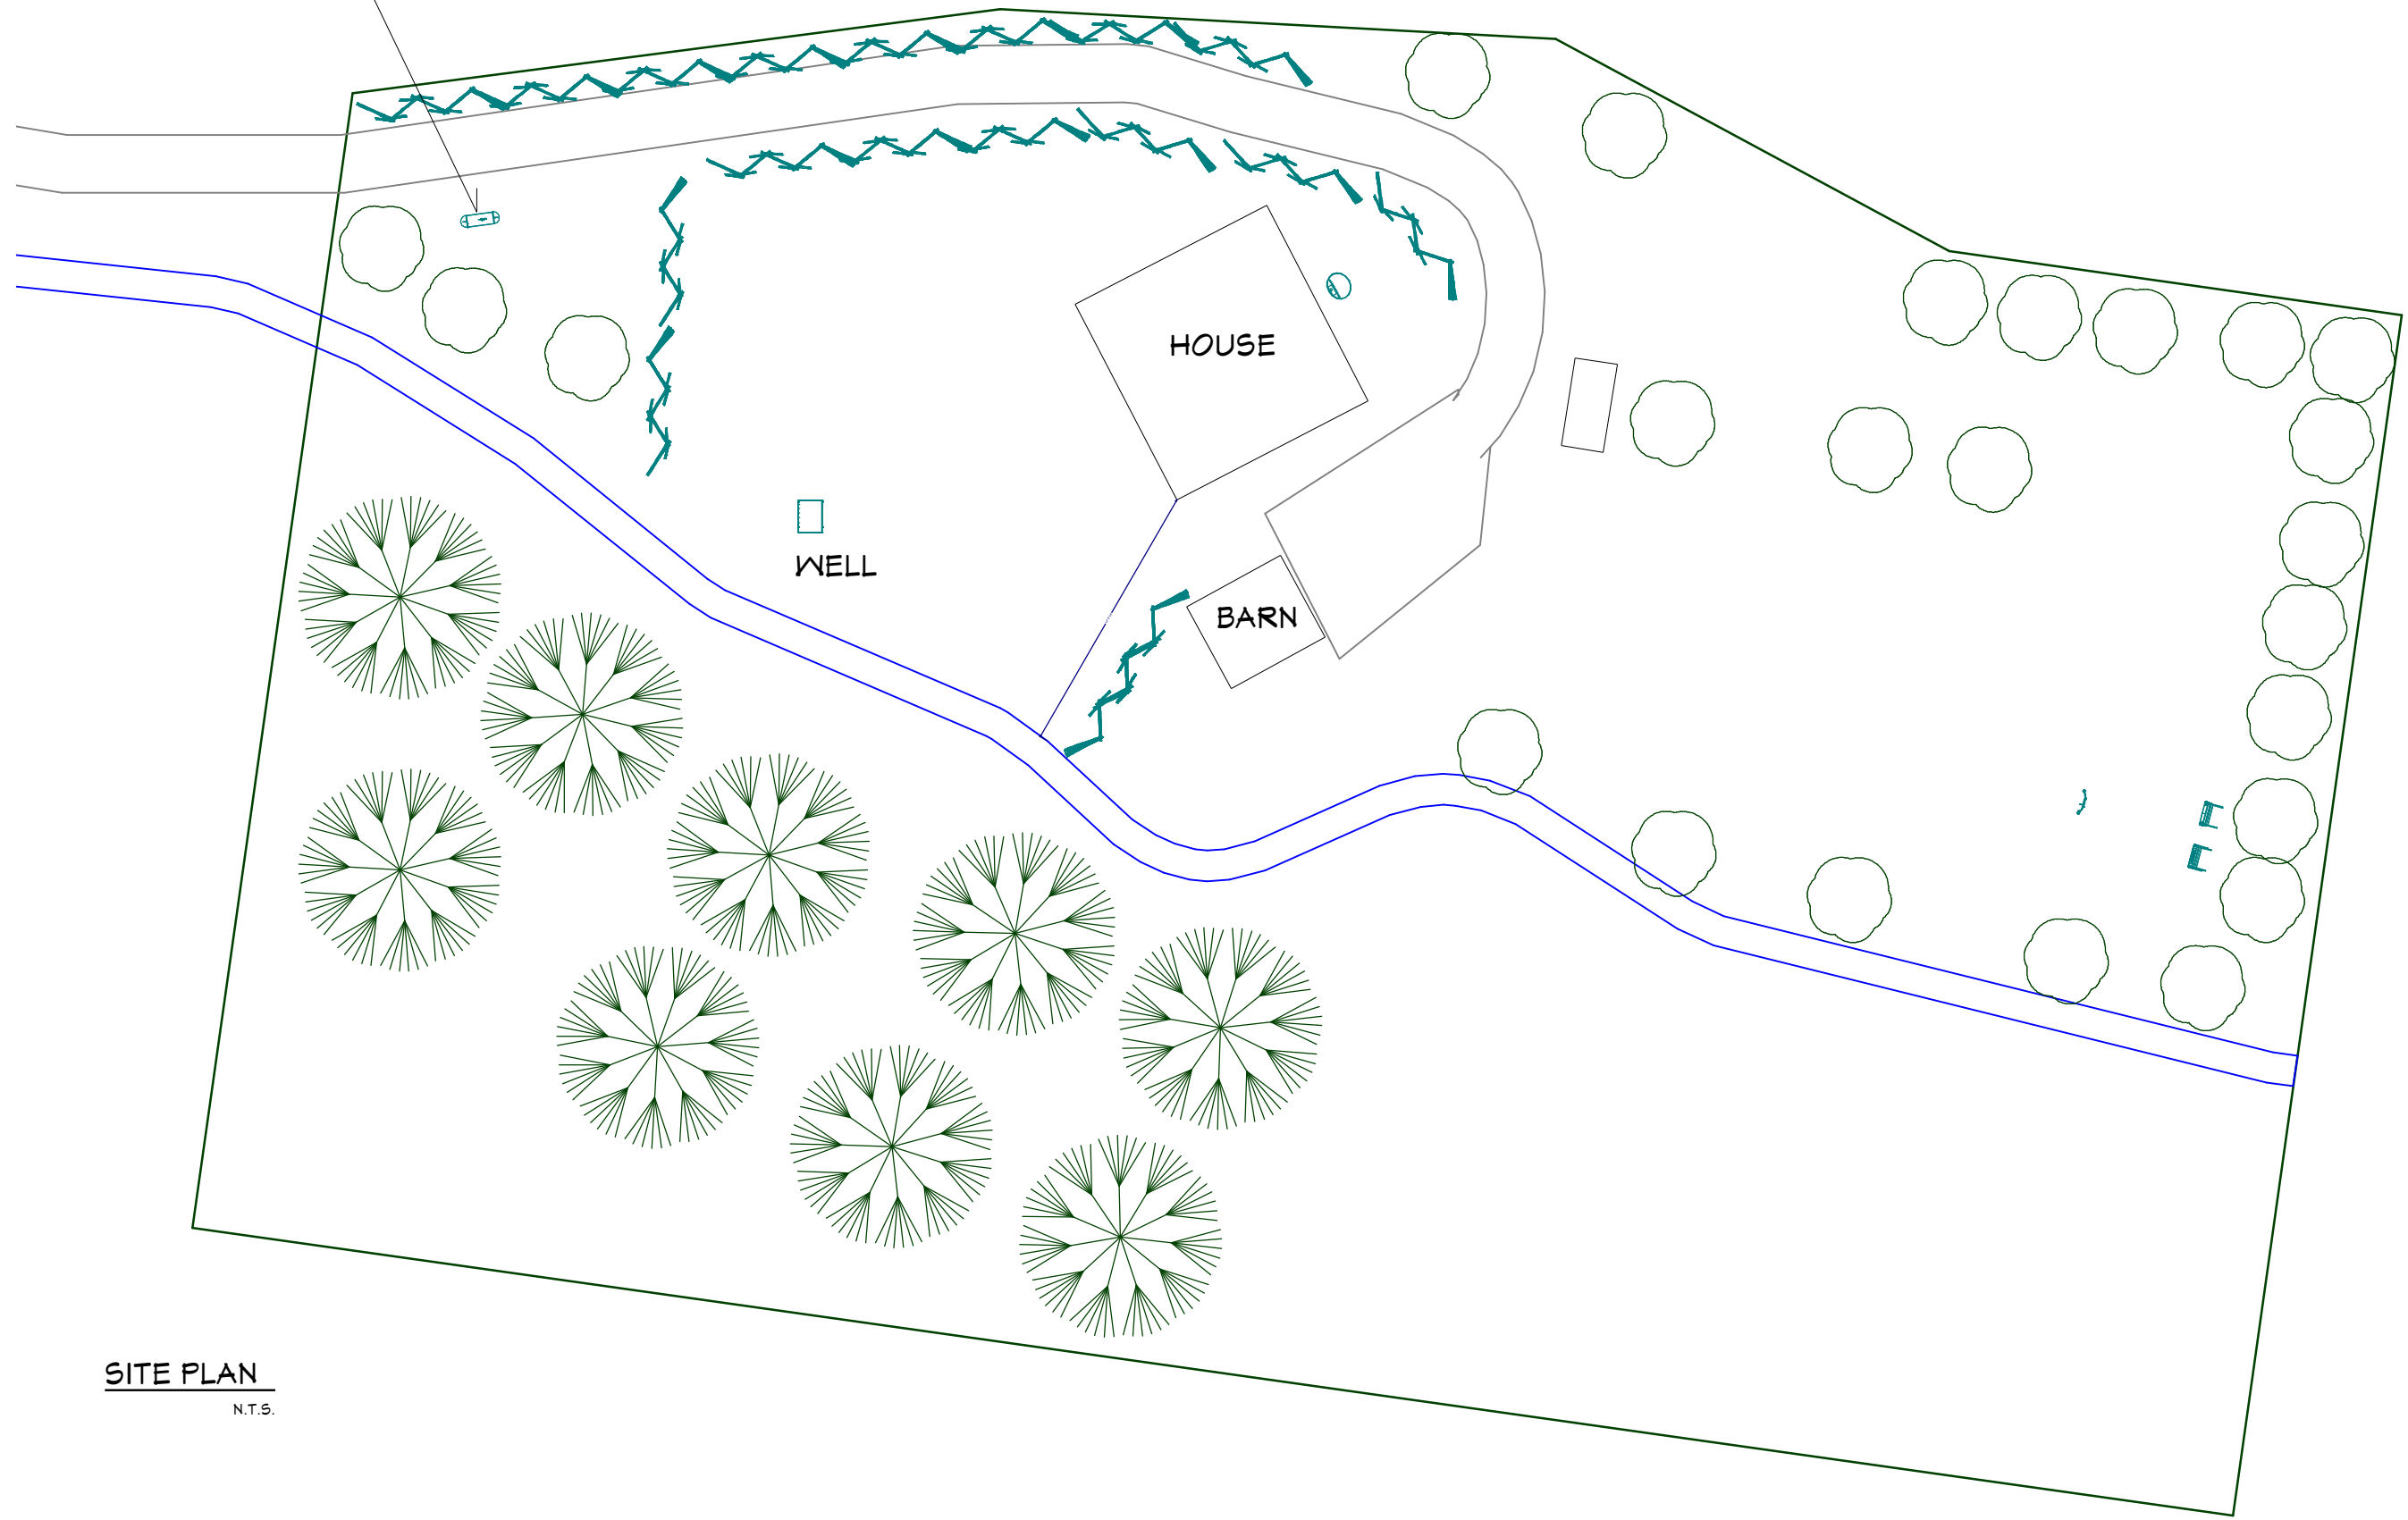


SITE PLAN
N.T.S.

SHEET NUMBER
1
REVISION #

 SITE PLAN
DRAWN BY: _____ ac
DATE: _____




Jersey City, NJ | © 2020
www.anthonycarrino.com


anthonycarrino design


FIRST FLOOR AS-BUILT

1/8" = 1'

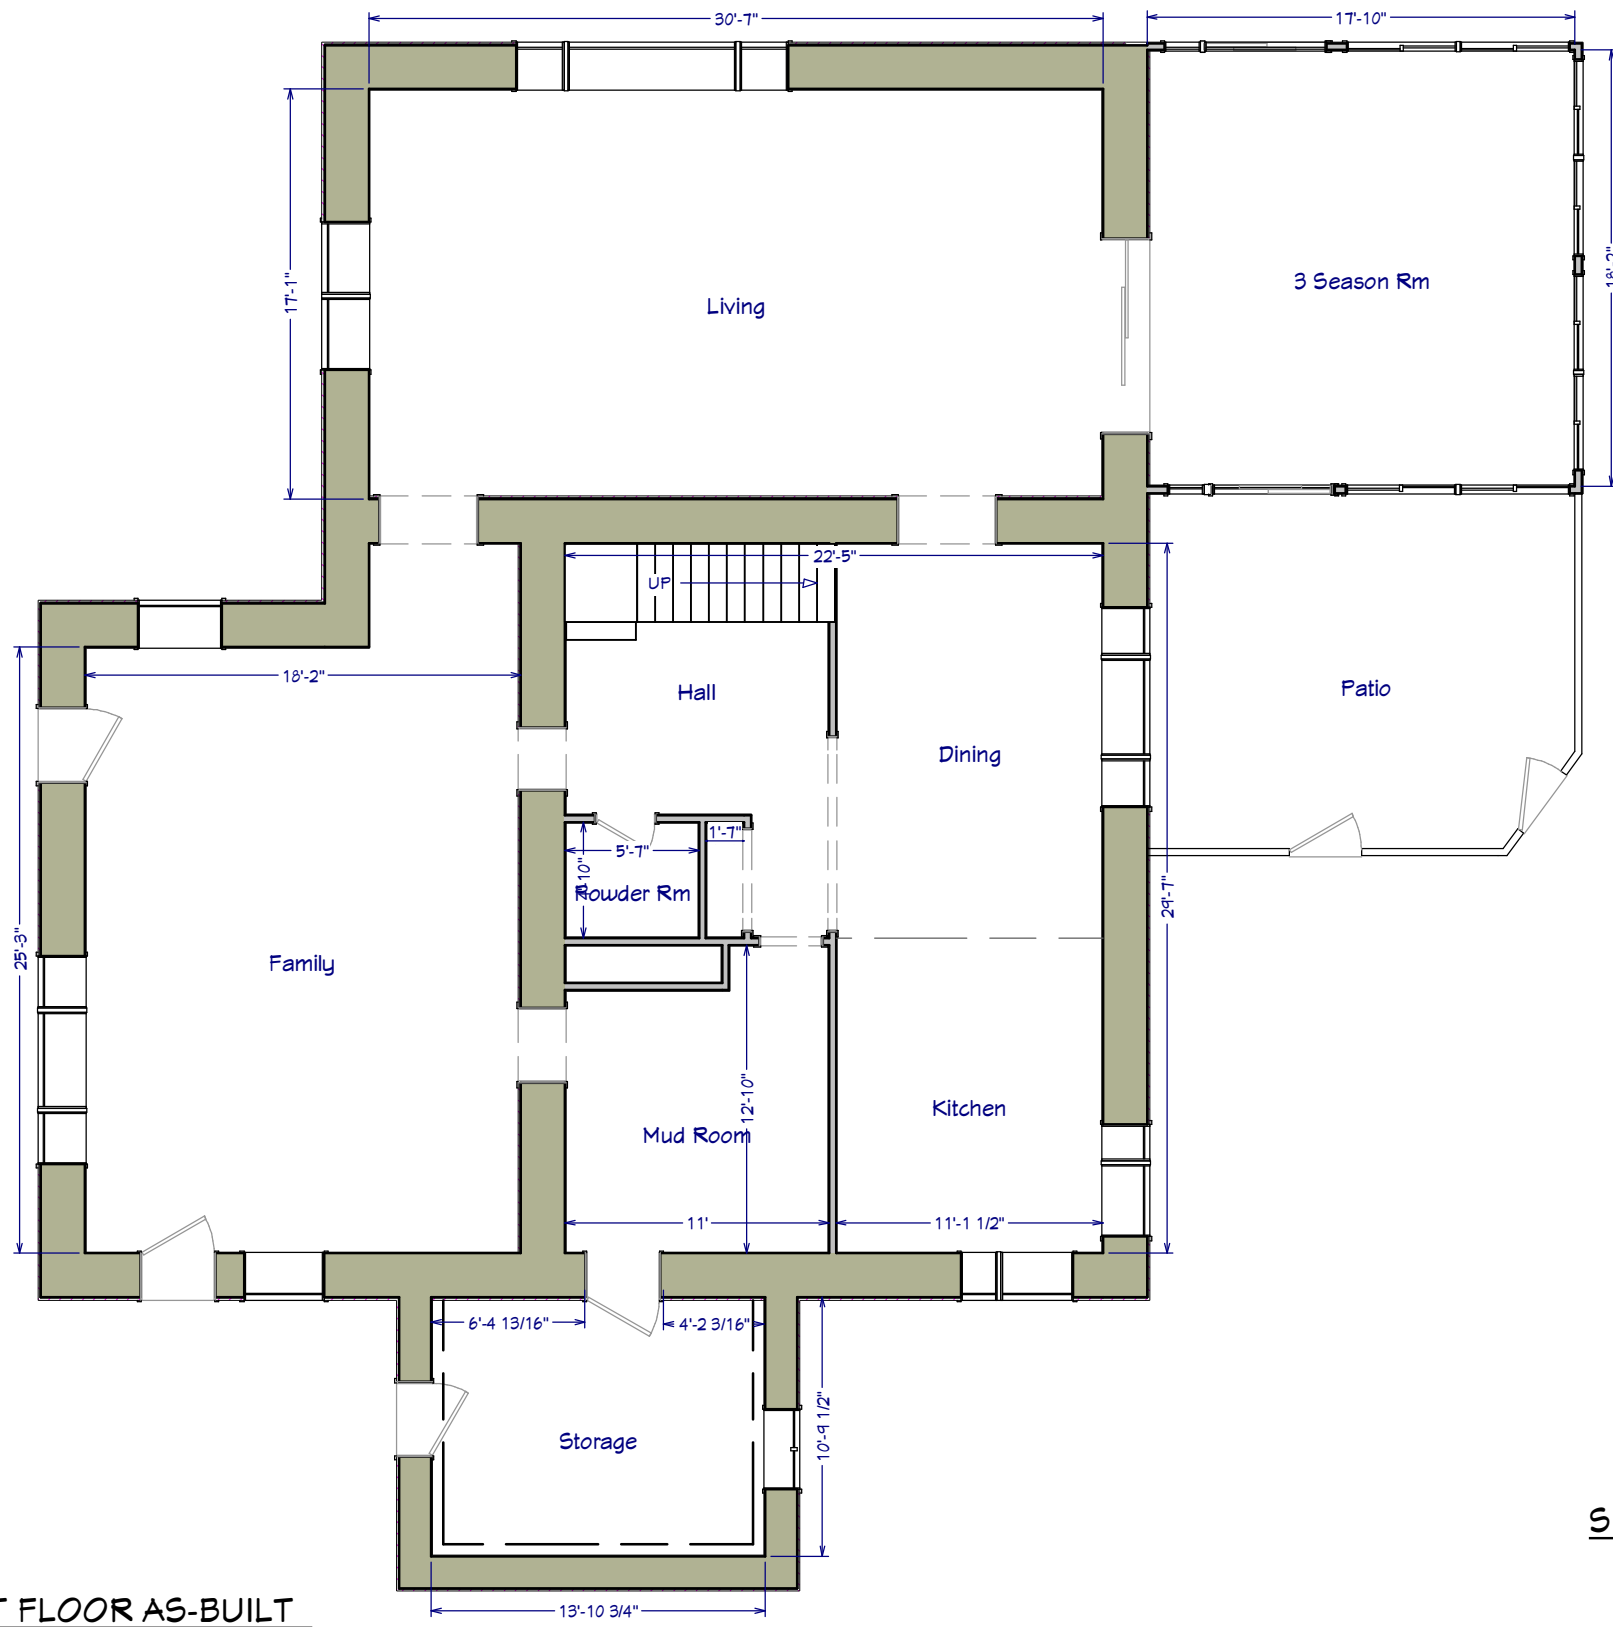


SECOND FLOOR AS-BUILT

1/8" = 1'

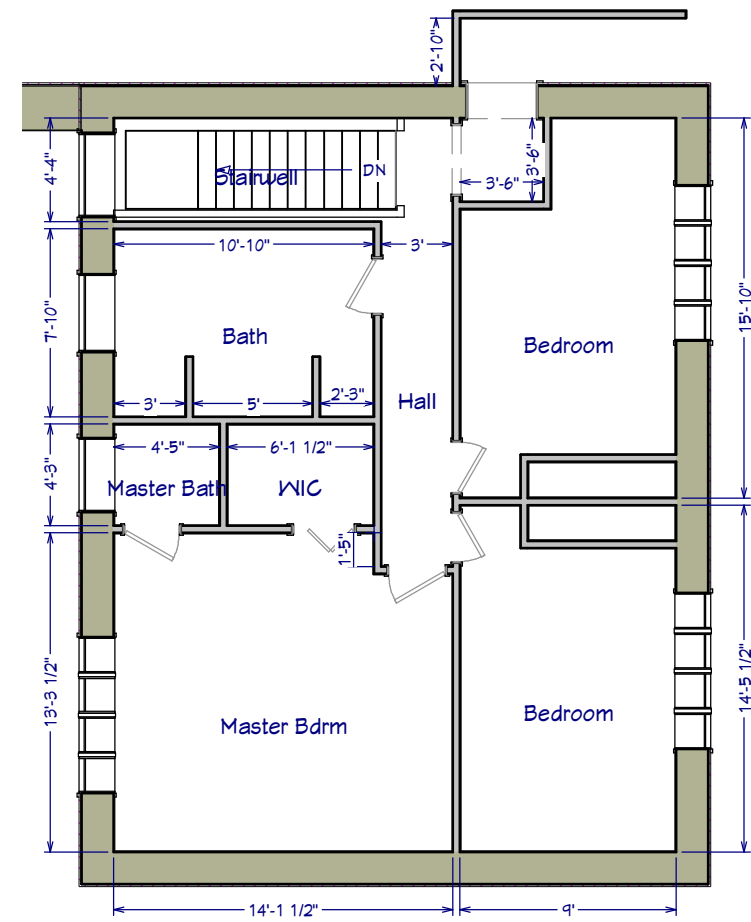


FIRST FLOOR PLAN

1/8" = 1'

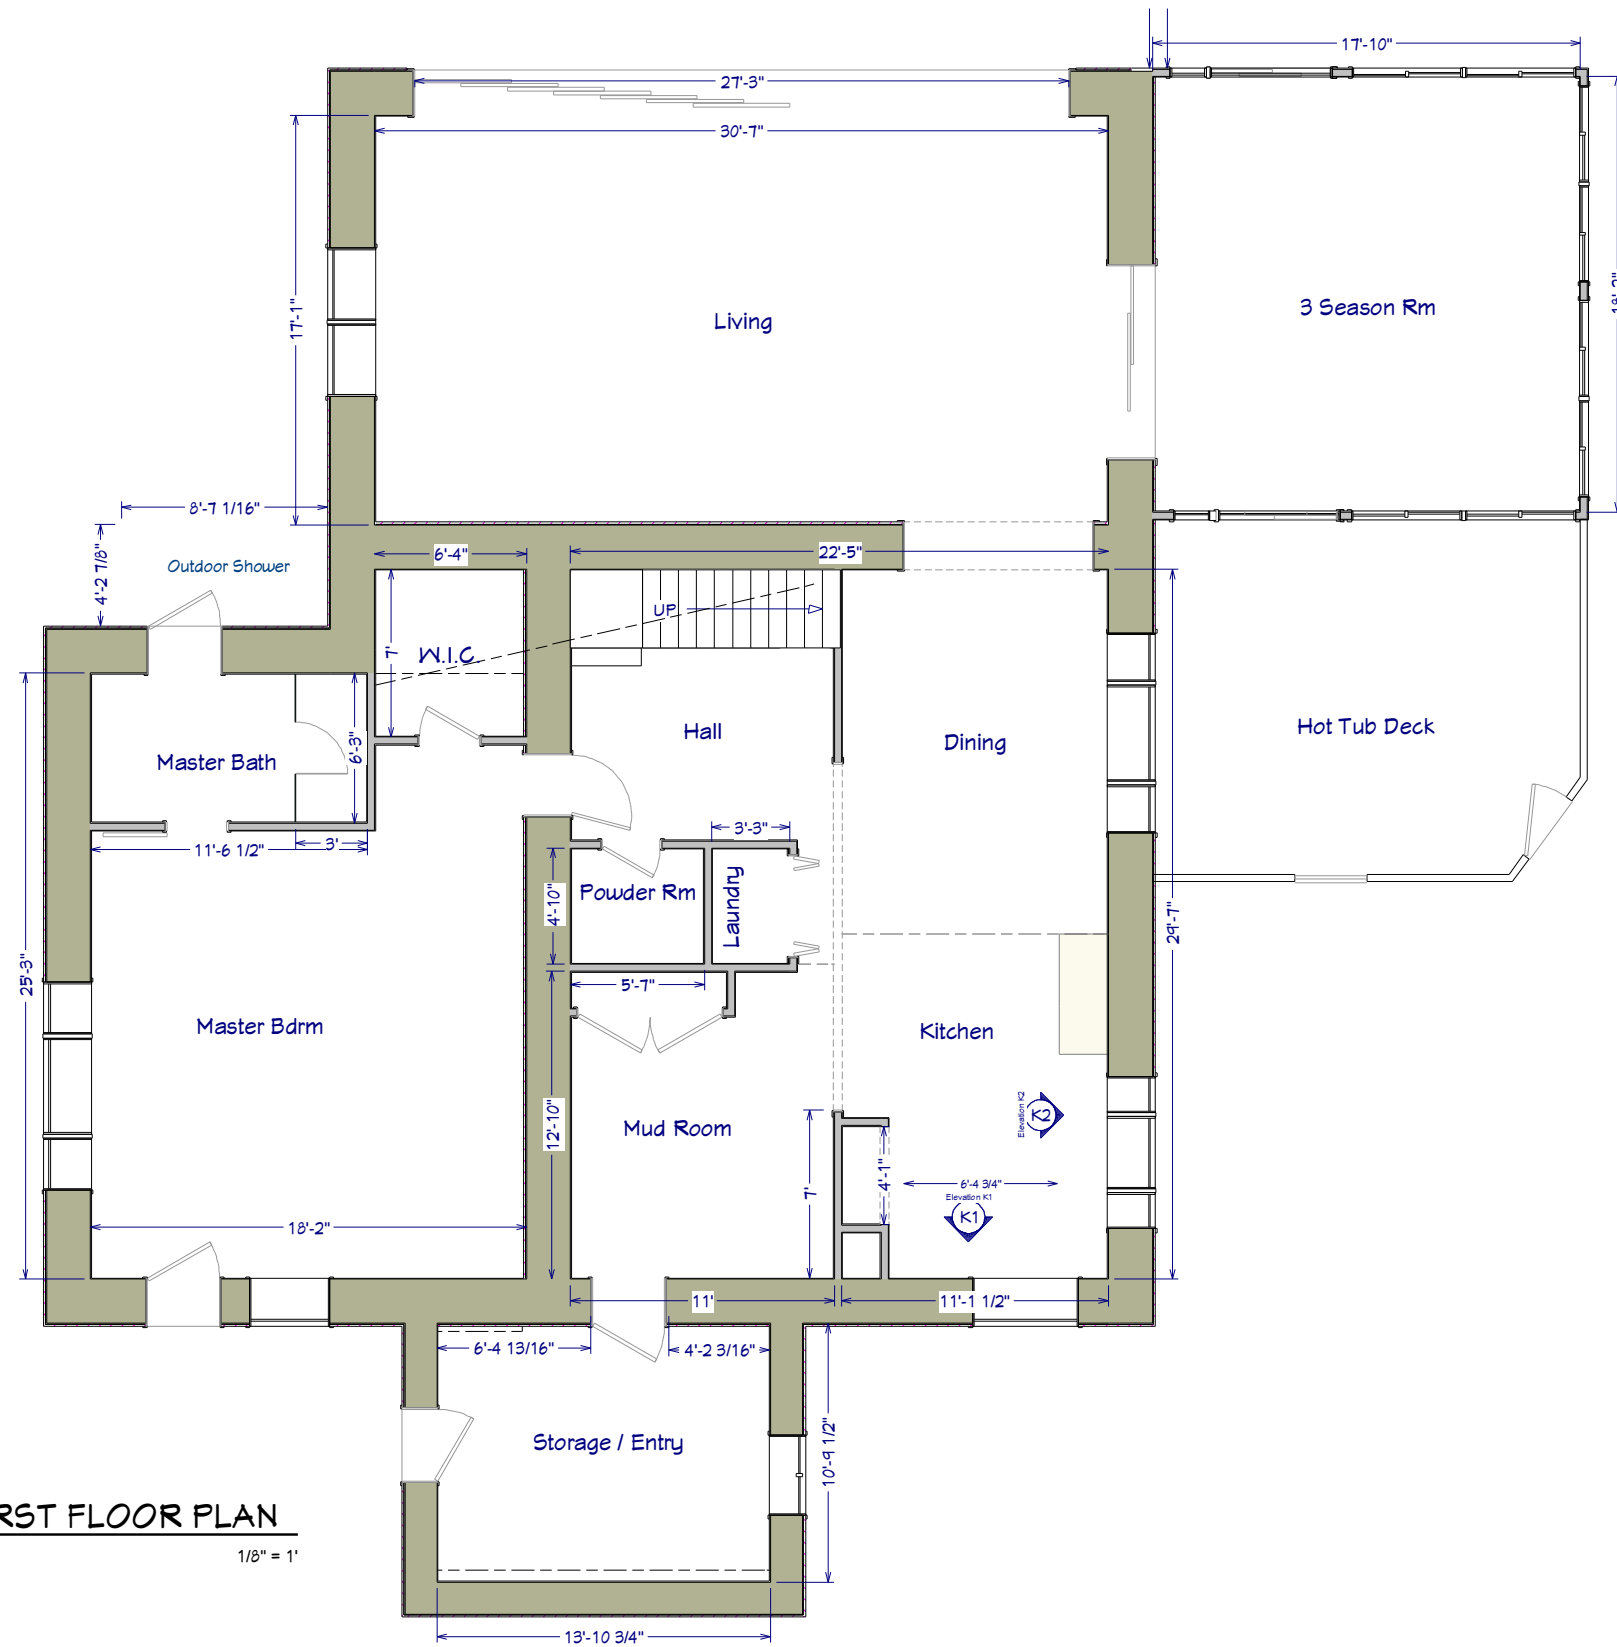

SECOND FLOOR PLAN

1/8" = 1'

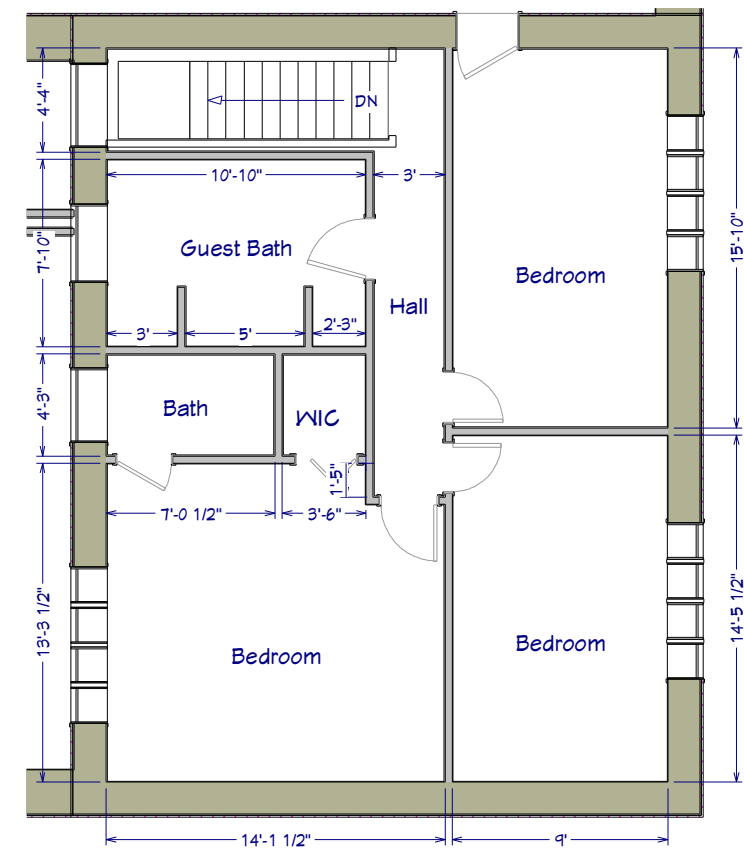

Jersey City, NJ | © 2020
www.anthonycarrino.com



FLOORPLAN


DRAWN BY: .ac

DATE:


SHEET NUMBER


3

REVISION #:

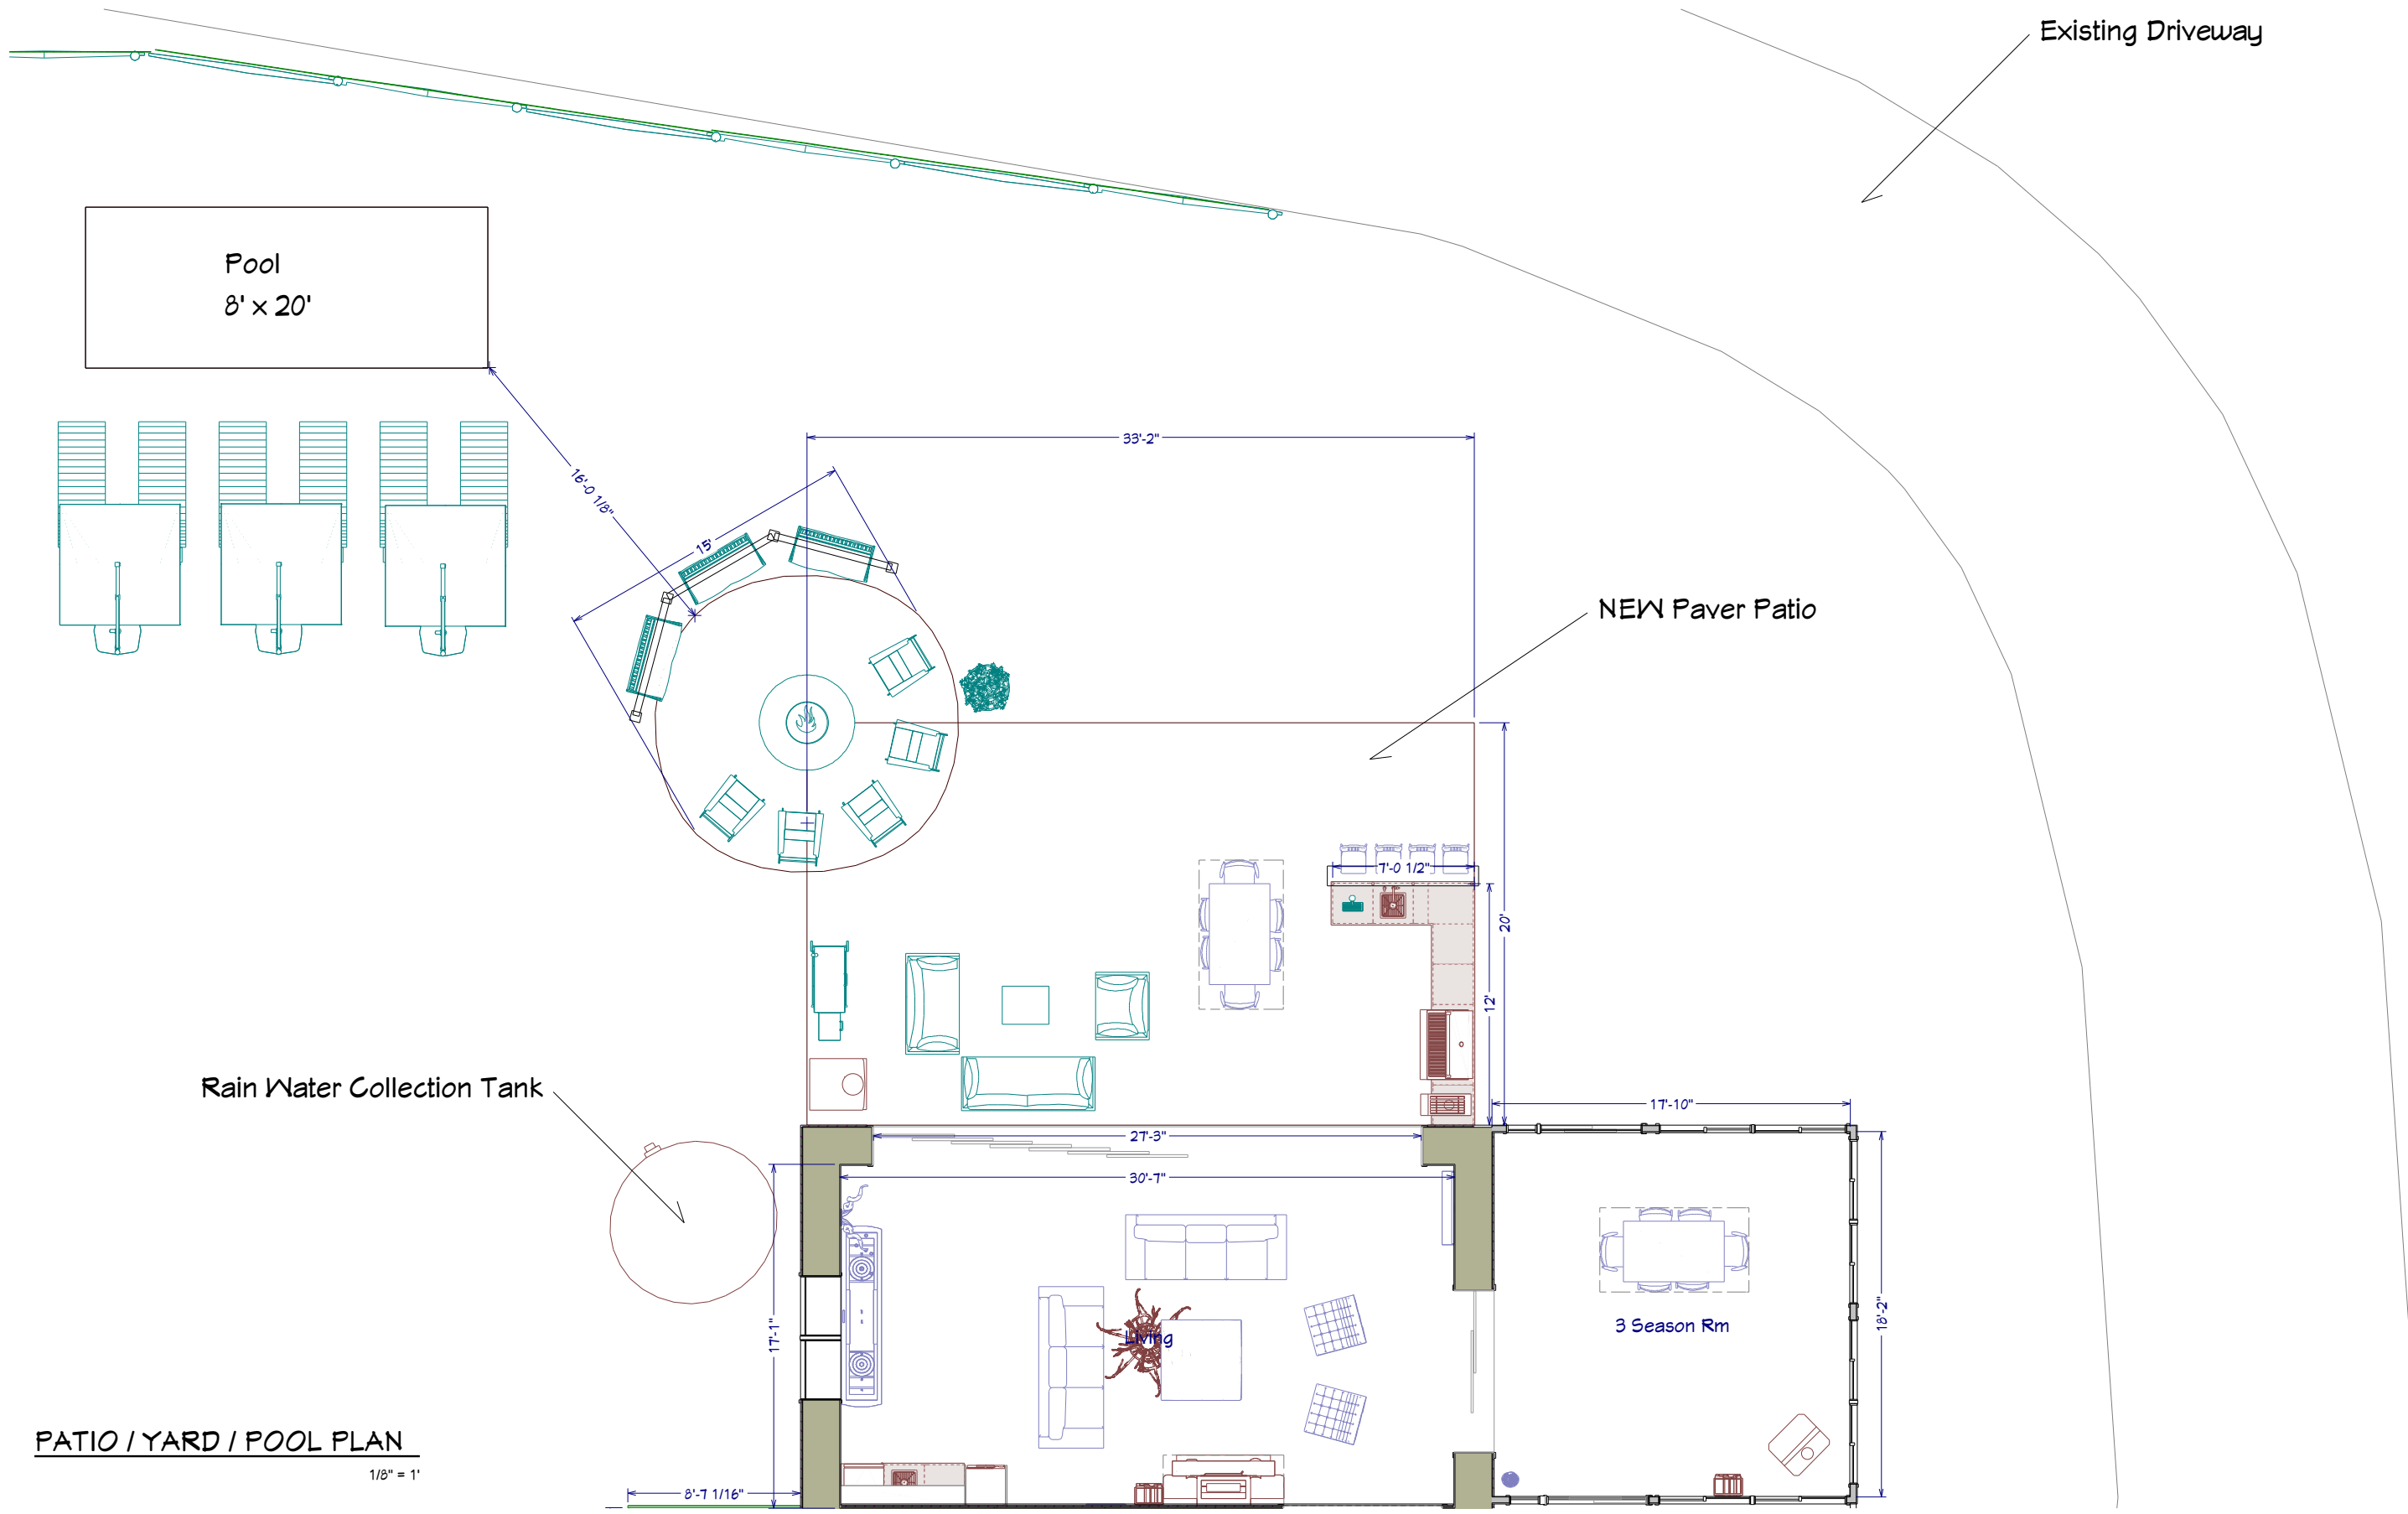


PATIO / YARD / POOL PLAN
 1/8" = 1'

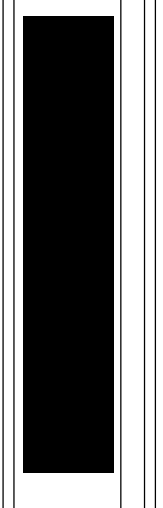



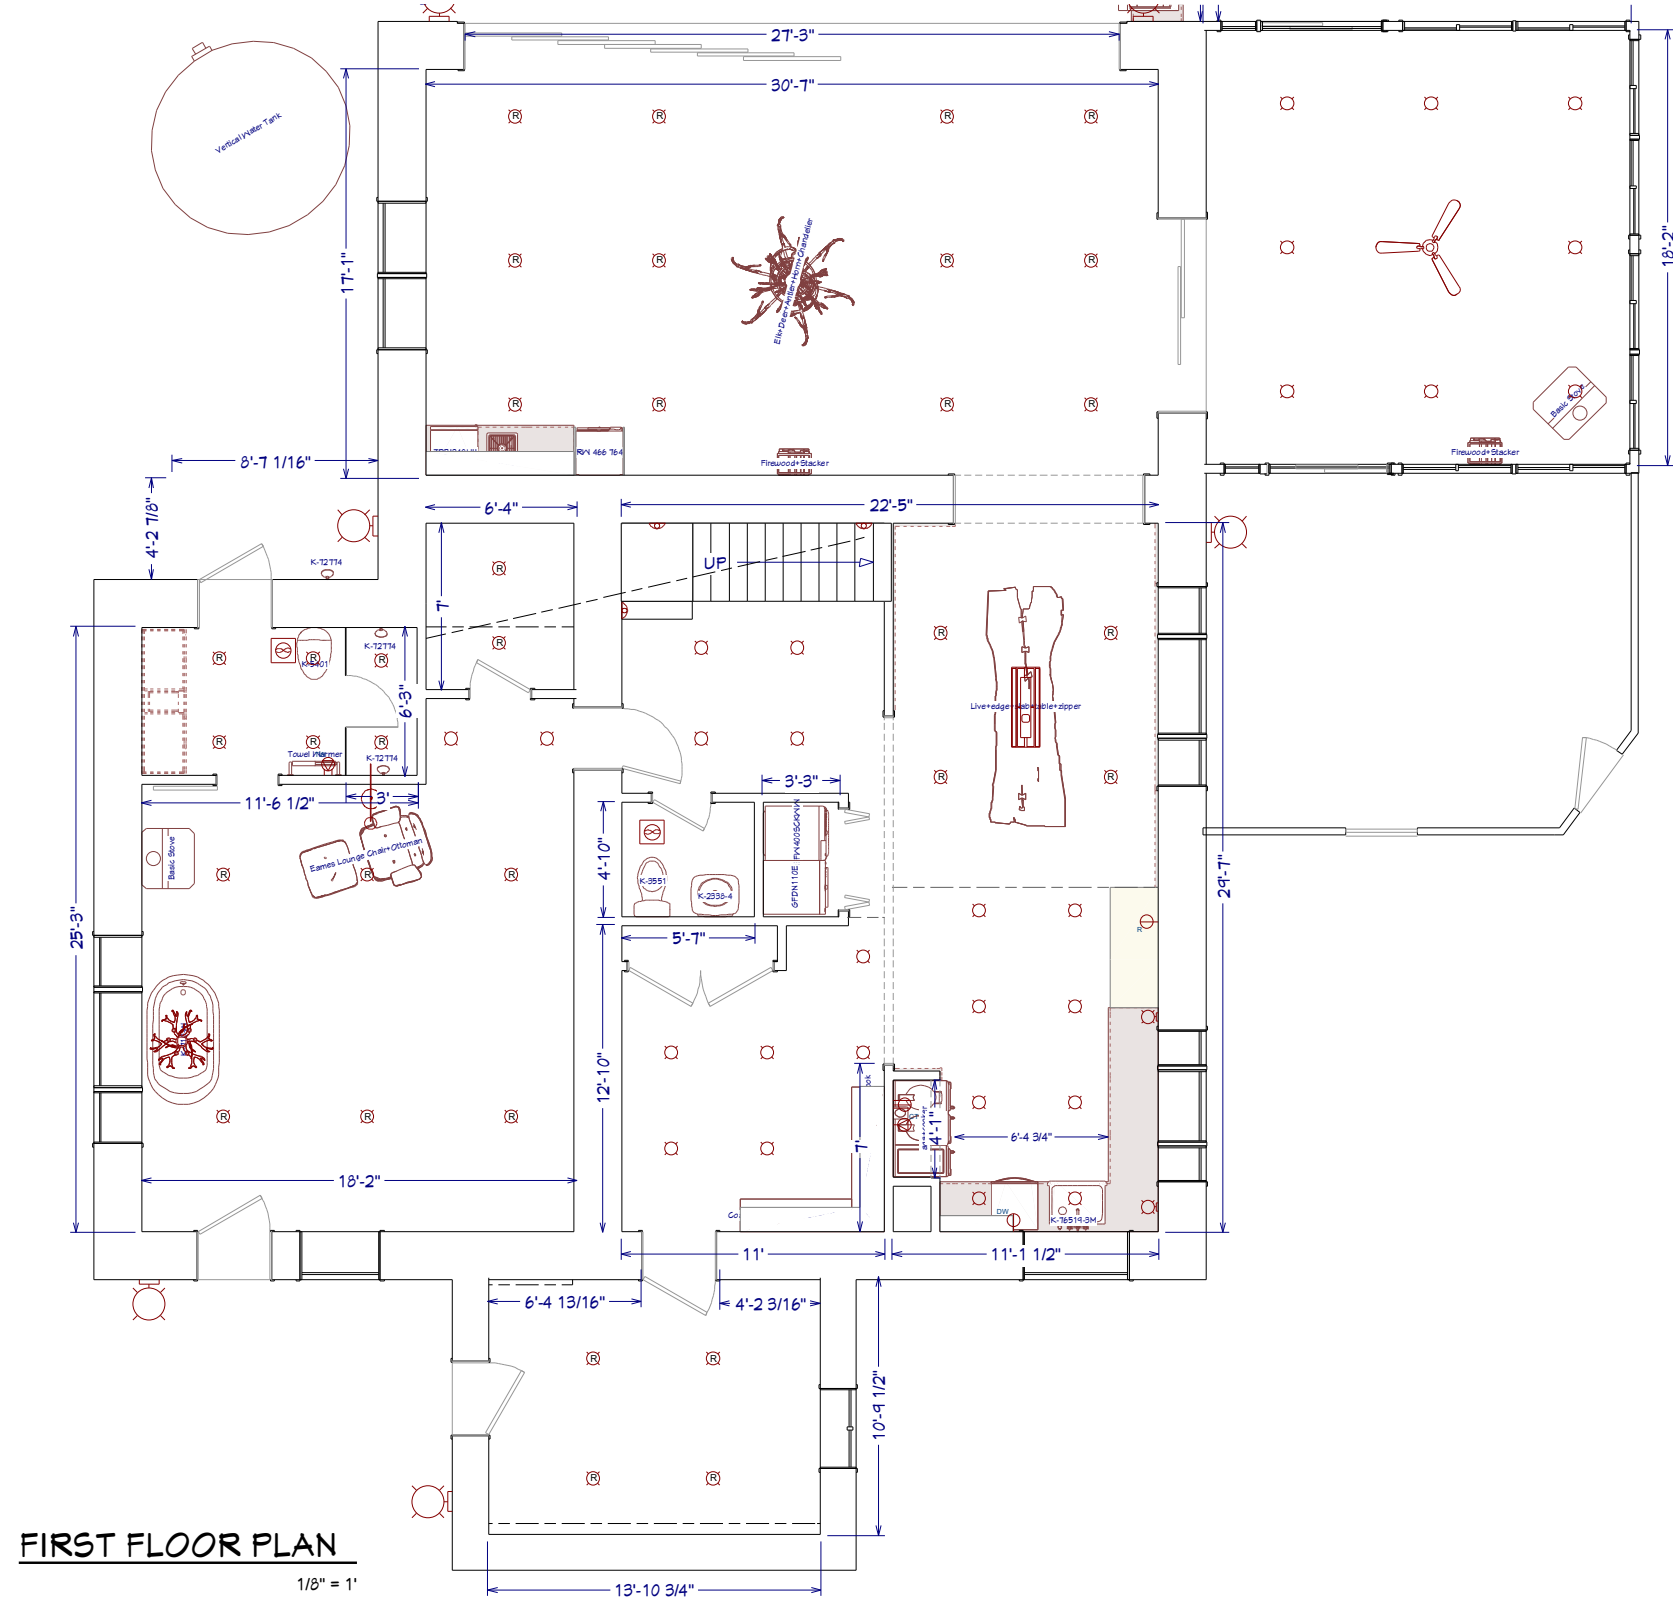


FIRST FLOOR PLAN
1/8" = 1'

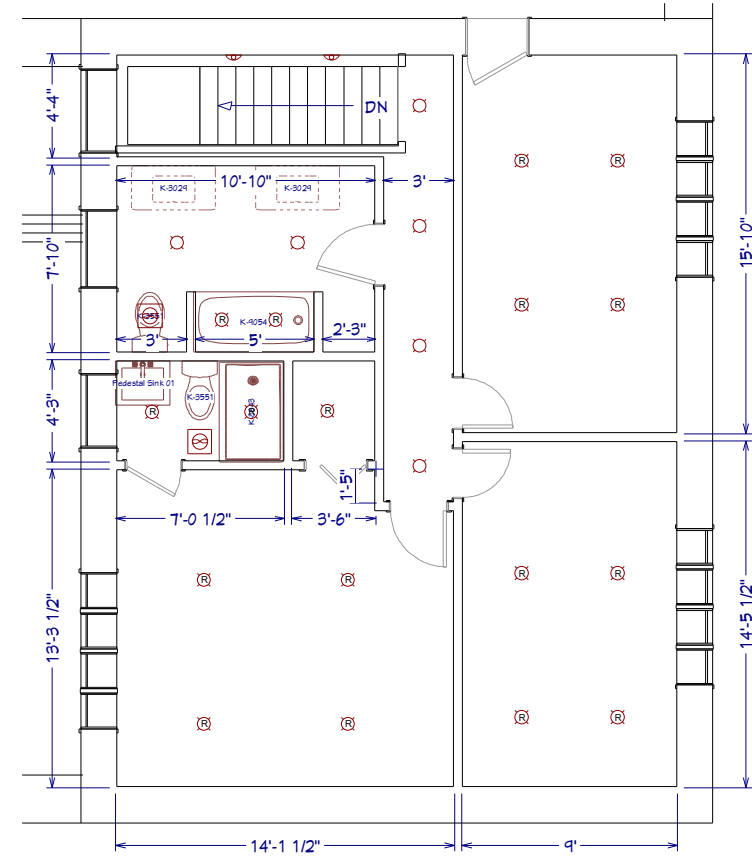

SECOND FLOOR PLAN
1/8" = 1'

 

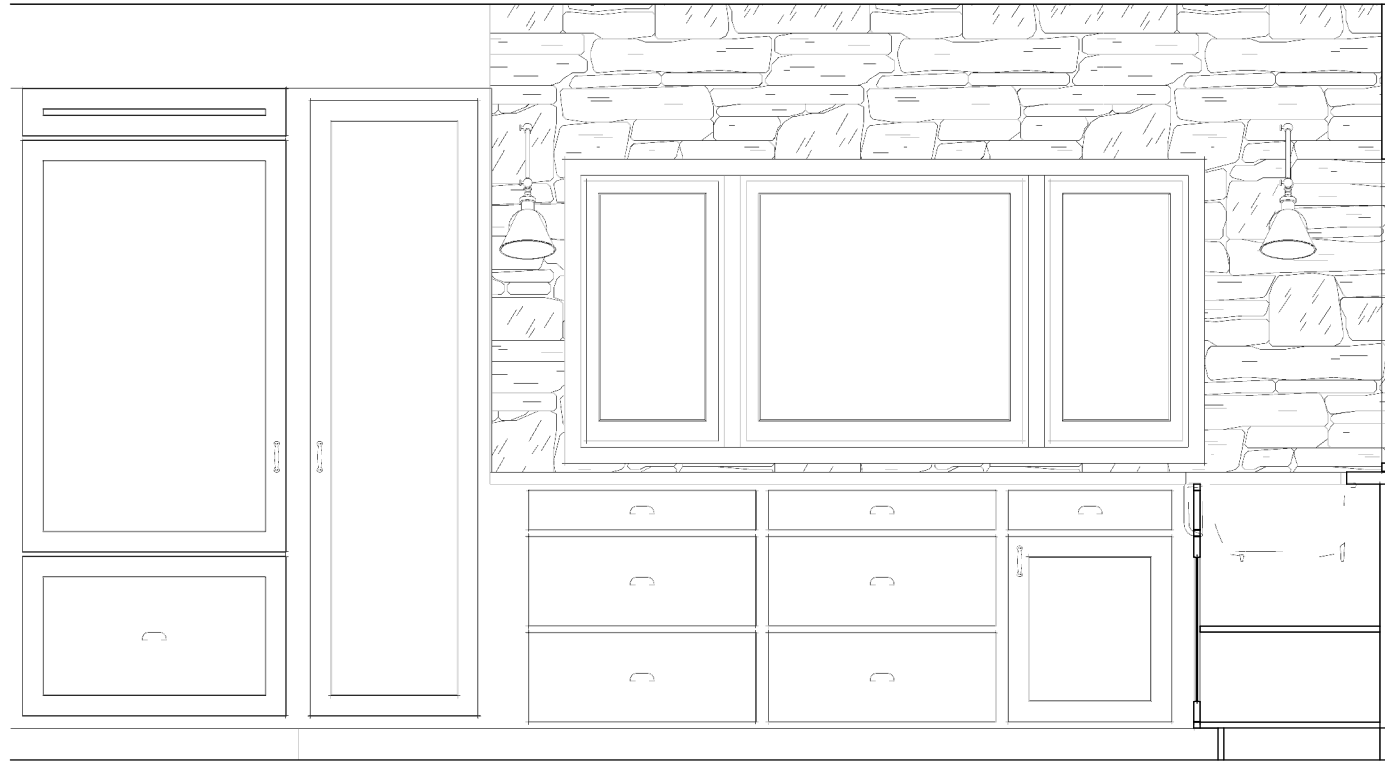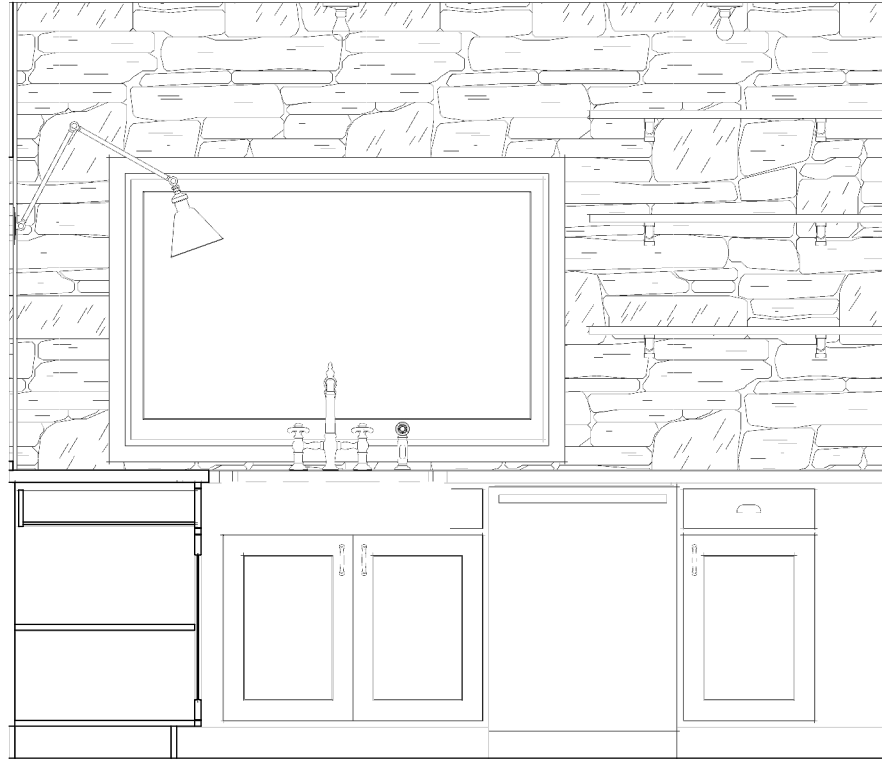


SHEET NUMBER
6

REVISION #

KITCHEN




DRAWN BY: _____
DATE: _____

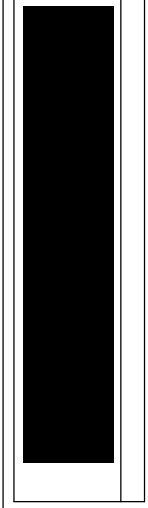

Jersey City, NJ | © 2020
www.anthonycarrino.com



anthonycarrino design

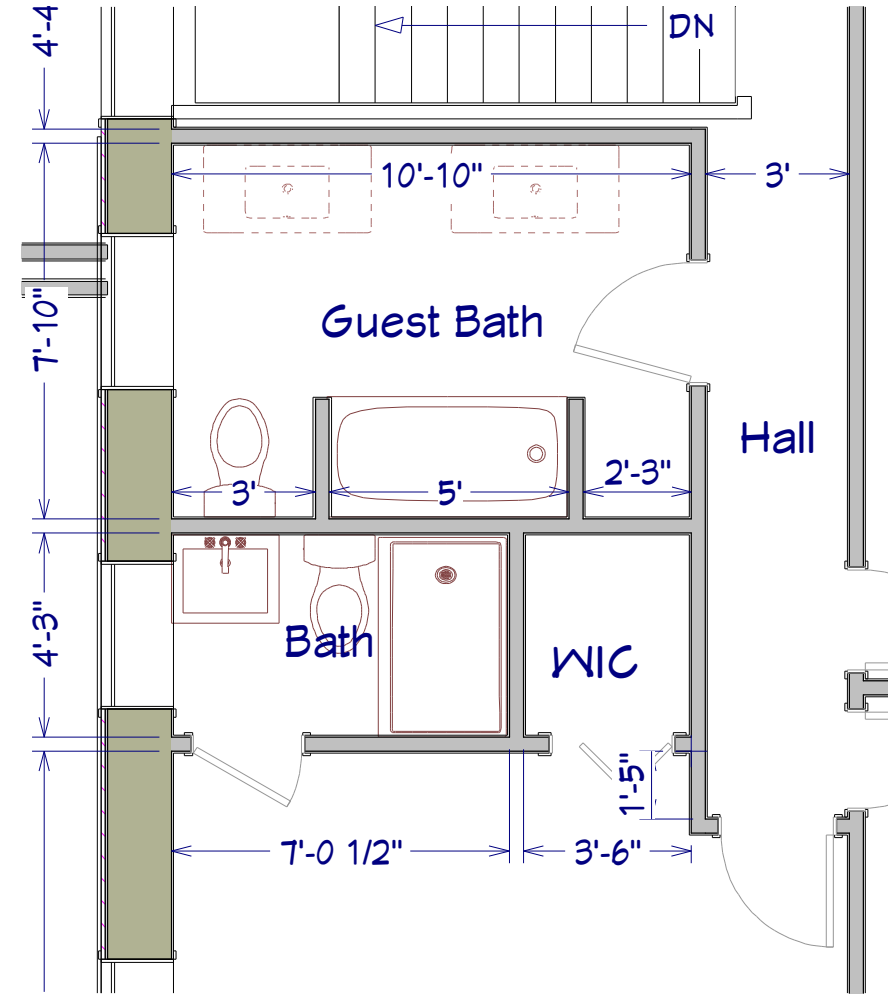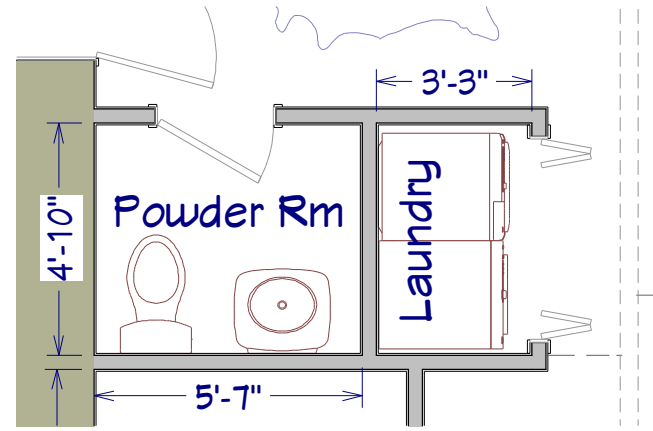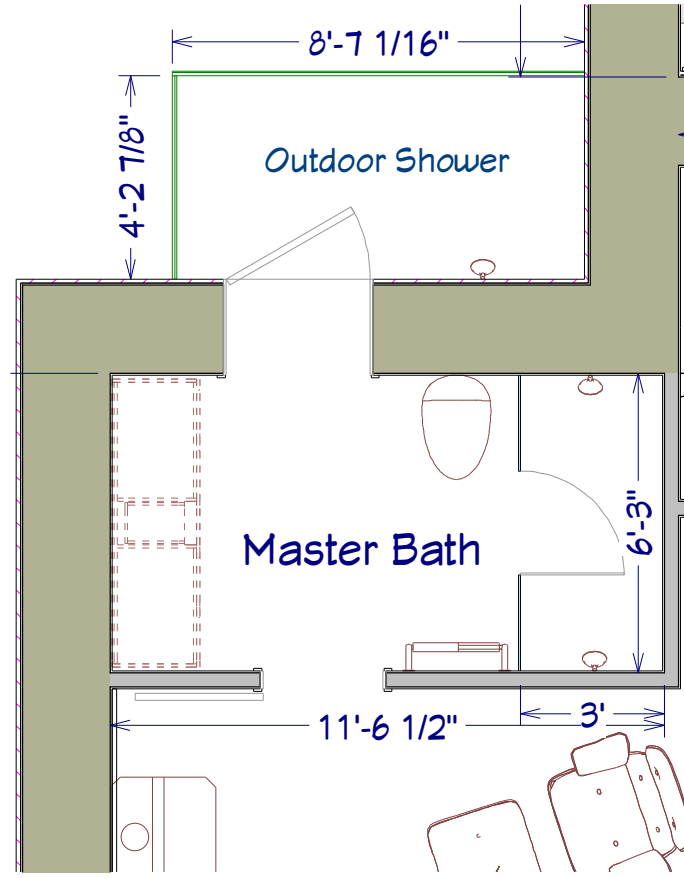

BATHROOM DETAILS

1/4" = 1'



BATHROOM DETAILS